

Lighting Key

Proposed Lighting

All fittings use narrow spectrum bulbs (between 4000 and 2700k) and/or low UV emitting bulb types.

All lighting used only for 50 no. 4 hour events per year



Temporary WC Pod Lighting; Warm-white LED down-lights mounted under roof overhang - removed for winter




Temporary Stage Lighting; Mains-powered colour LED spot lights mounted on 3m ht timber posts.



Mains-powered temporary warm-white Festoon lights strung between posts - removed for winter



Temporary drive lights: solar-powered LED spotlights - removed for winter

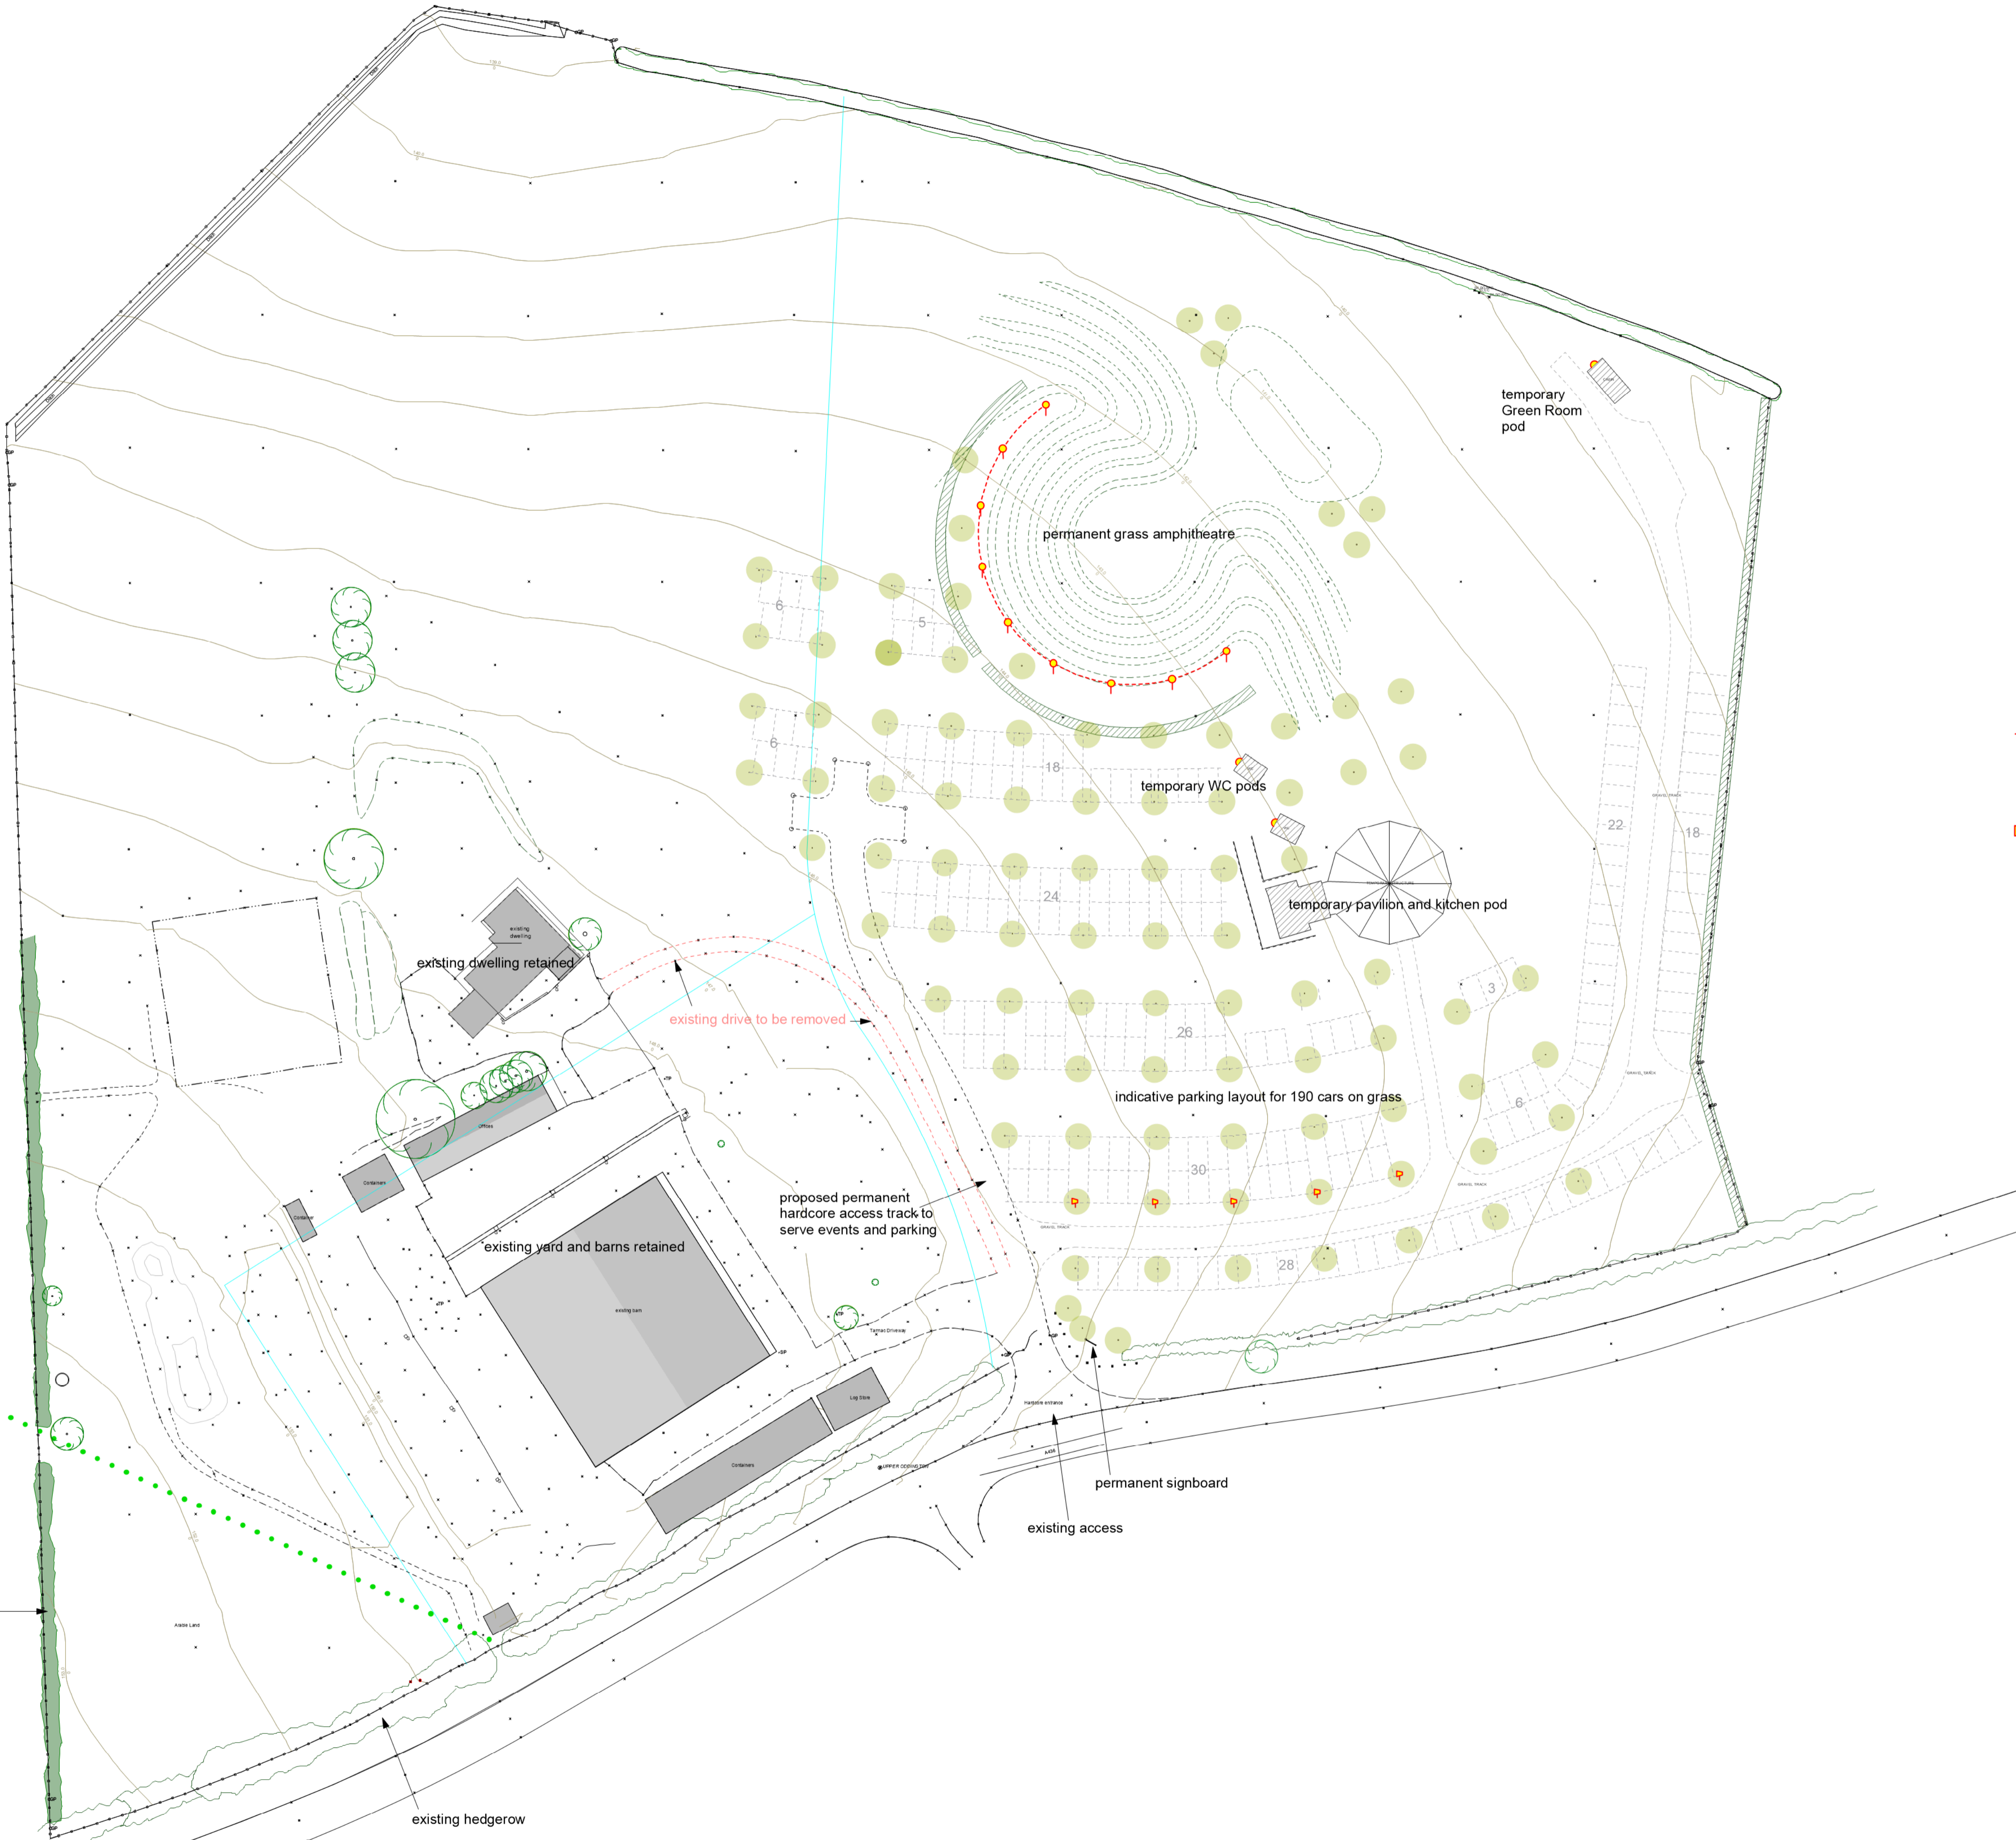

Rev - 11.10.22 1st issue

Portus + Whitton landscape architects
Portus+Whitton LLP
58 Ashcroft Road Cirencester
Gloucestershire GL7 1QX
T: 01285 644335 F: 01285 644336
E: contact@portusandwhitton.co.uk

client	Berry Bank Park Limited												
project	Berry Bank, Oddington												
drawn	As-built Exterior Event Lighting												
scale	1:500	scale at site	A1	date	Sept 2022	project no.	1699	print	L	sheet no.	3	rev	-
purpose of issue	W.I.P. for CLIENT APPROVAL												